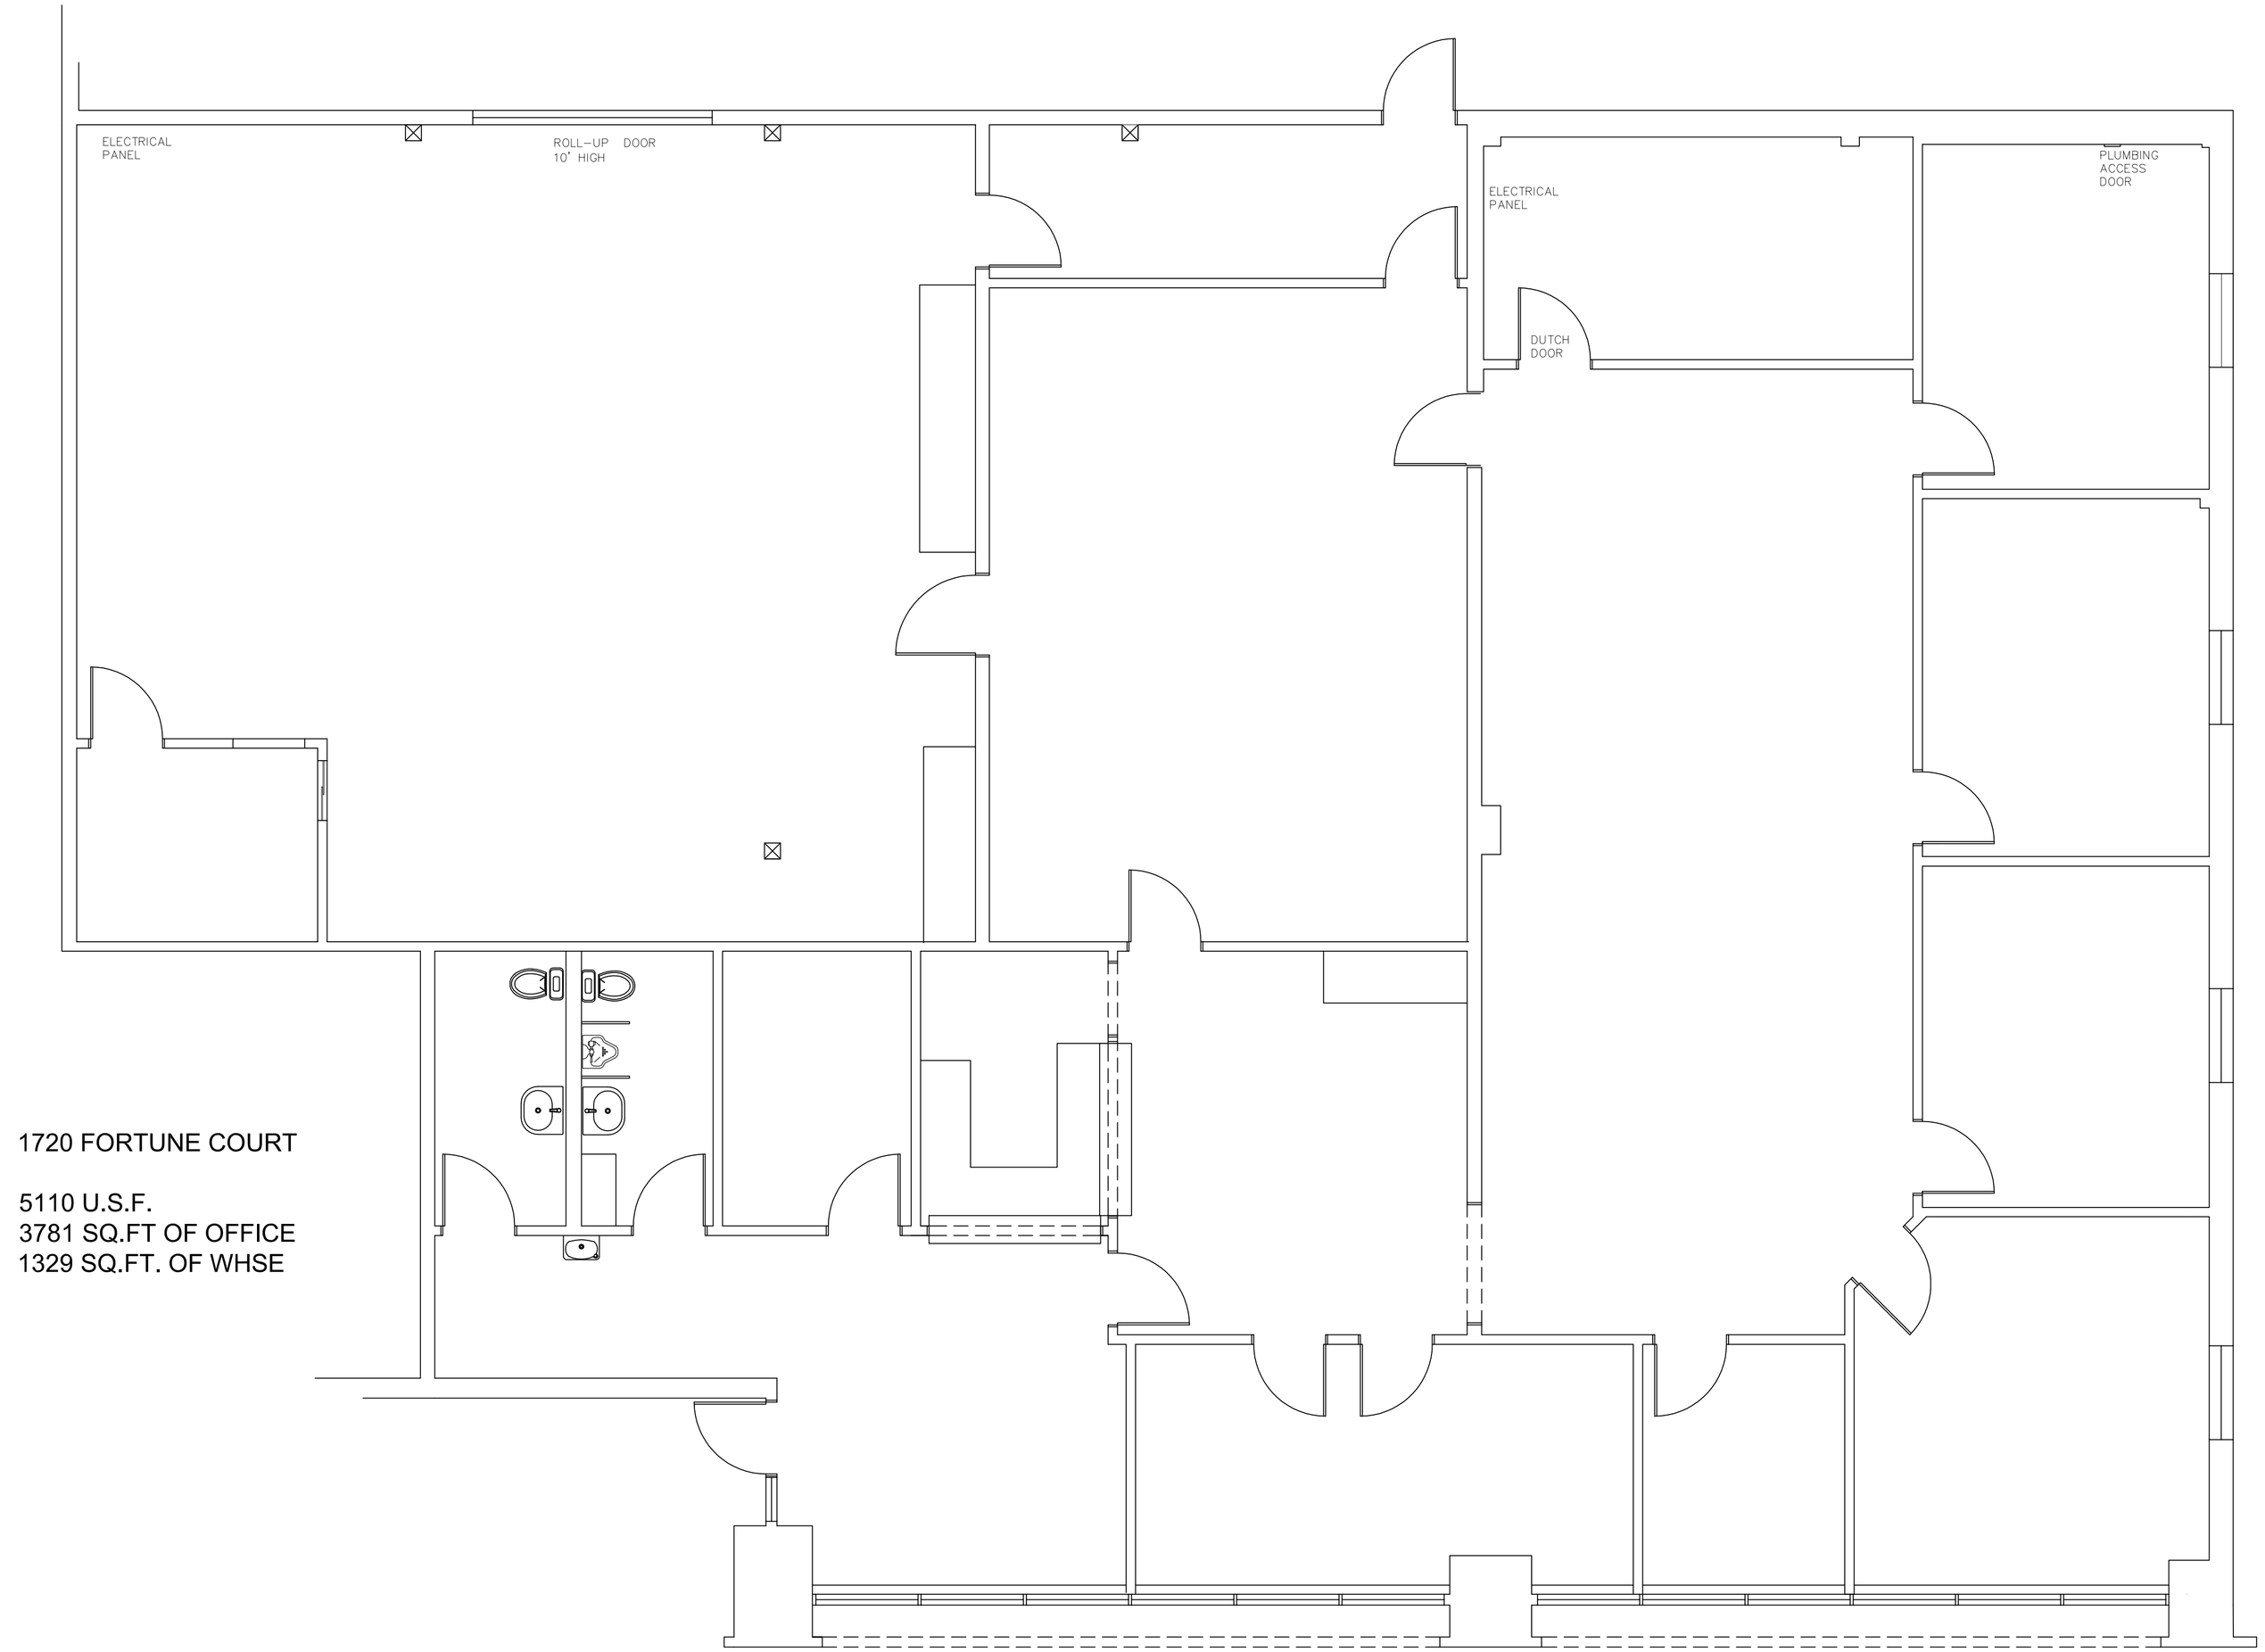

1720 FORTUNE COURT

5110 U.S.F.
3781 SQ.FT OF OFFICE
1329 SQ.FT. OF WHSE

PREPARED BY: THOMISZER DESIGN AND CONSTRUCTION, LLC
56 Summertree Court, Nicholasville, KY
Direct Questions To : 859-913-7233

AS-BUILT DRAWINGS FOR:
1720 FORTUNE COURT
LEXINGTON, KY

SCALE 1/4" = 1'-0"
DATE FEBRUARY 15, 2009
JOB NO.
DRAWN
CHECKED

TITLE

SHEET NO.